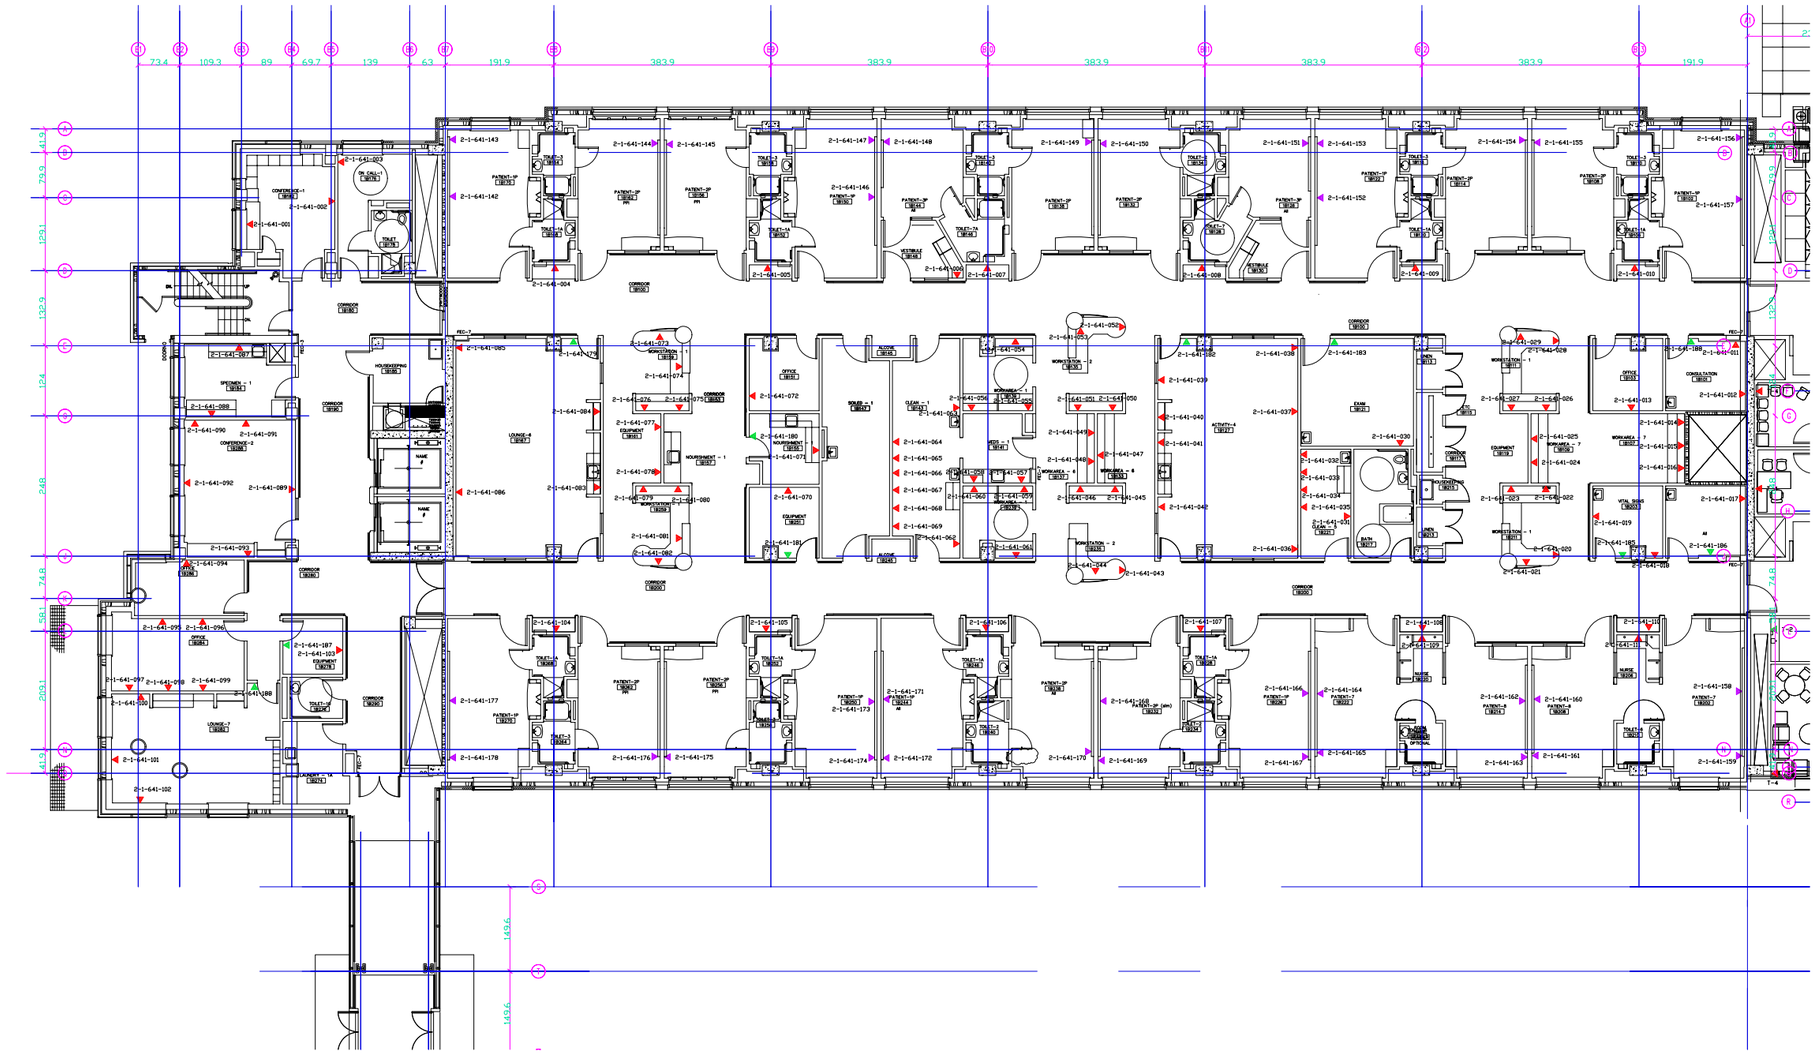

N

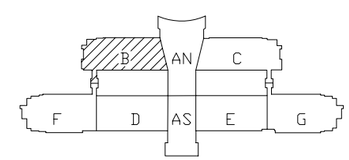

KEY PLAN

Architecture
Engineering
Planning
Interior Design
Computer Aided Design

REVISIONS				
ZONE	REV	DESCRIPTION	DATE	APPROVED

JOB NO.

SIZE E

SCALE: 1/8"=1'

JOB TITLE: NIH - CRC CABLING SYSTEMS

FLOOR/AREA: FLOOR 1/AREA B

DRWG TITLE: PARTIAL PLAN

NATIONAL INSTITUTES OF HEALTH

DESIGNED BY:CIT/DNST
T. LIGHTNER
DIV. NIH/CIT/DNST

DEPARTMENT OF HEALTH & HUMAN SERVICES USA

TT2.1.B

DATE: 01/31/03

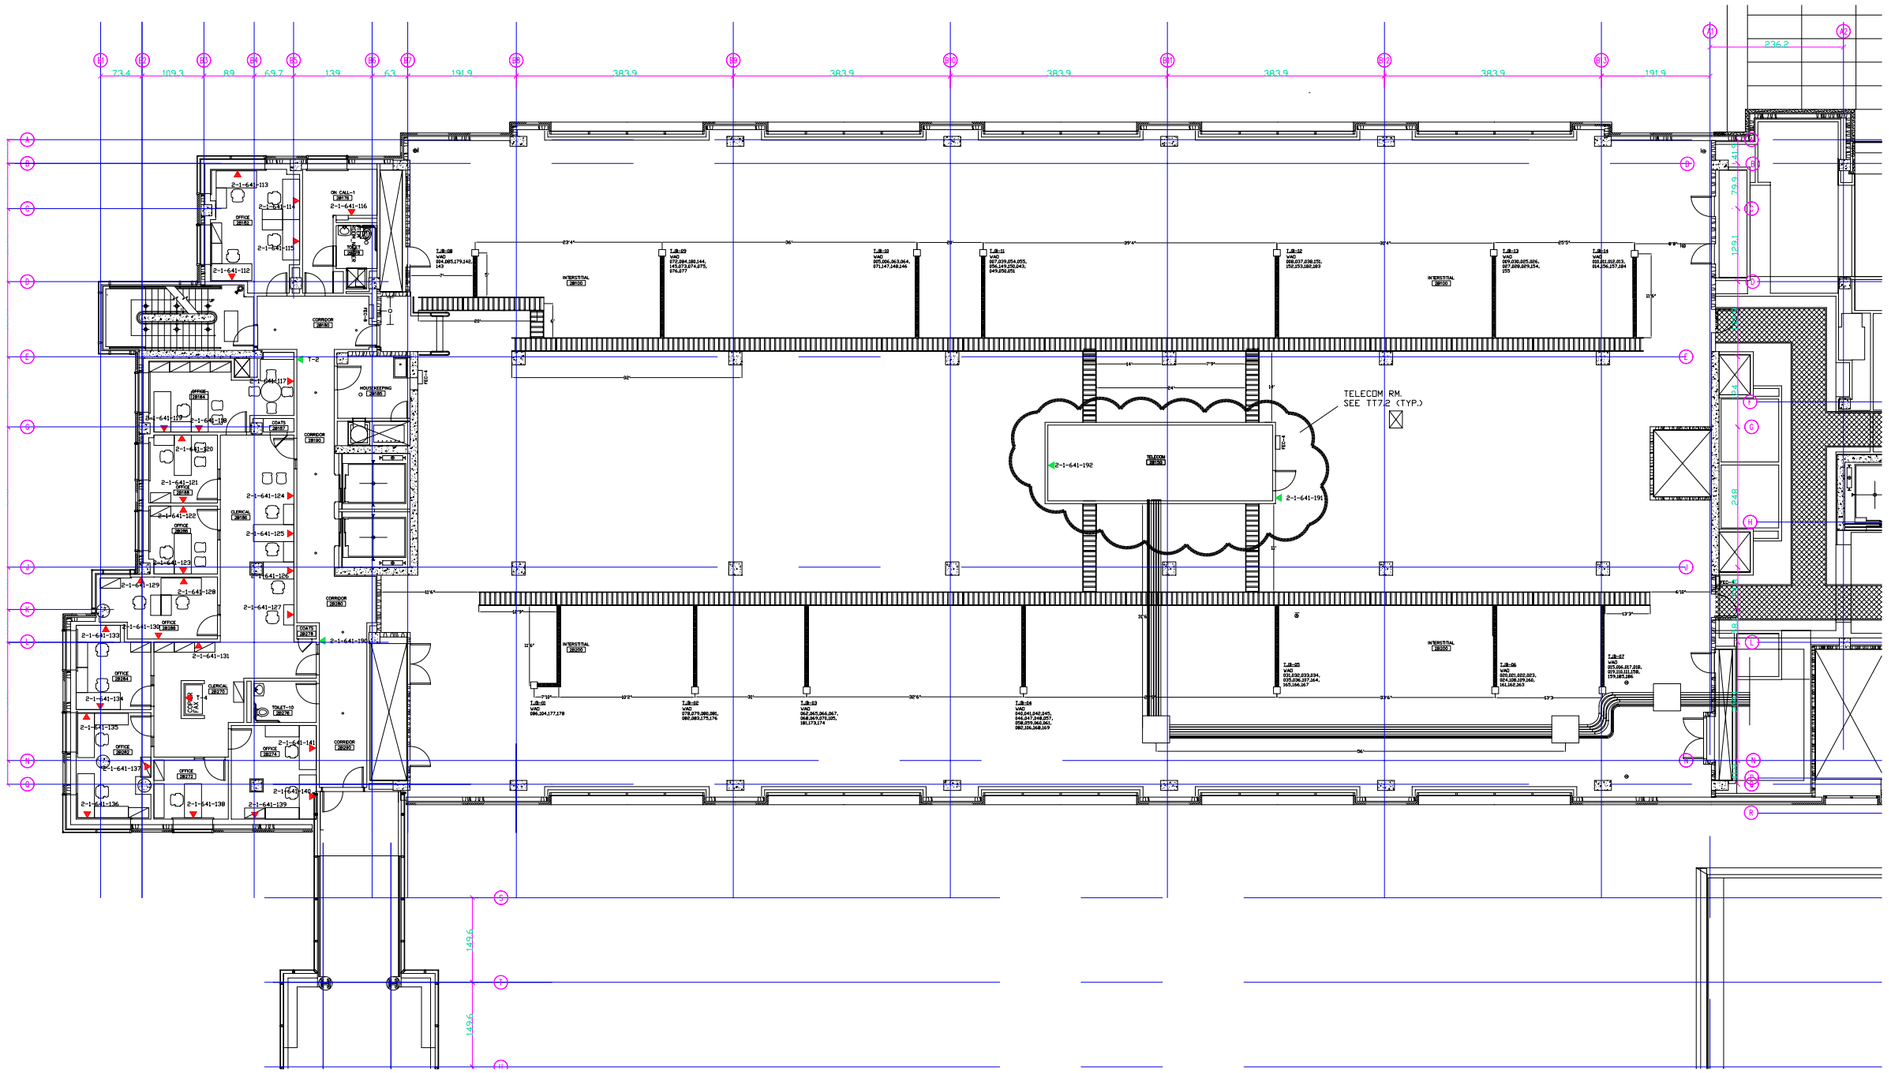

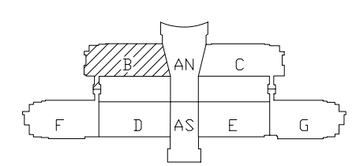

KEY PLAN

Architecture
Engineering
Planning
Interior Design
Computer Aided Design

REVISIONS				
ZONE	REV	DESCRIPTION	DATE	APPROVED

JOB NO.

SIZE E

SCALE: 1/8"=1'

JOB TITLE: NIH - CRC CABLING SYSTEMS

FLOOR/ AREA: FLOOR 2/ AREA B

DRWG TITLE: PARTIAL PLAN

NATIONAL INSTITUTES OF HEALTH

DESIGNED BY:CIT/DNST
T. LIGHTNER
DIV. NIH/CIT/DNST

DEPARTMENT OF HEALTH & HUMAN SERVICES USA

TT2.2.B

DATE: 01/31/03

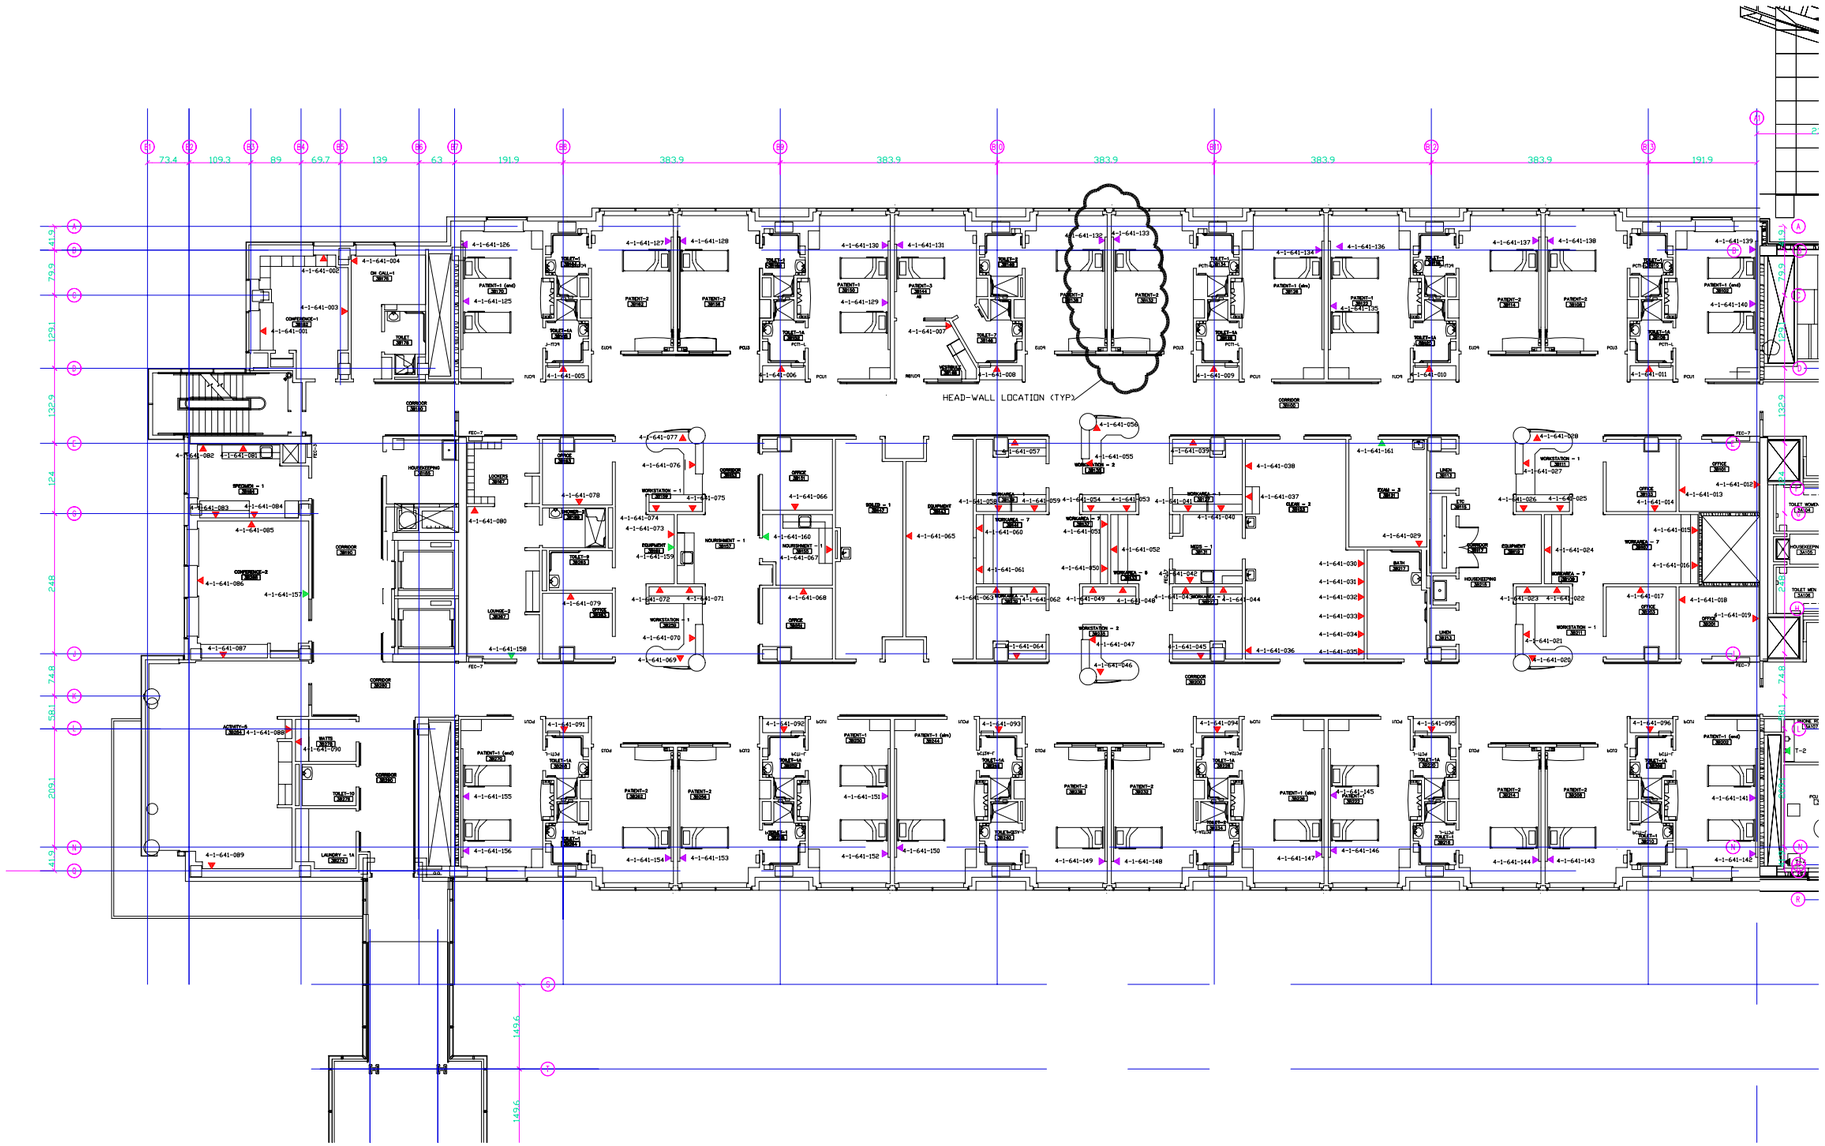

N

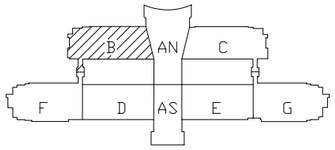

KEY PLAN

Architecture
Engineering
Planning
Interior Design
Computer Aided Design

REVISIONS			
ZONE	REV	DESCRIPTION	DATE	APPROVED

JOB NO.

SIZE E

SCALE: 1/8"=1'

JOB TITLE: NIH - CRC CABLING SYSTEMS

FLOOR/AREA: FLOOR 3/AREA B

DRWG TITLE: PARTIAL PLAN

NATIONAL INSTITUTES OF HEALTH

DESIGNED BY: CIT/DNST
T. LIGHTNER
DIV. NIH/CIT/DNST

DEPARTMENT OF HEALTH & HUMAN SERVICES USA

TT2.3.B

DATE: 01/31/03

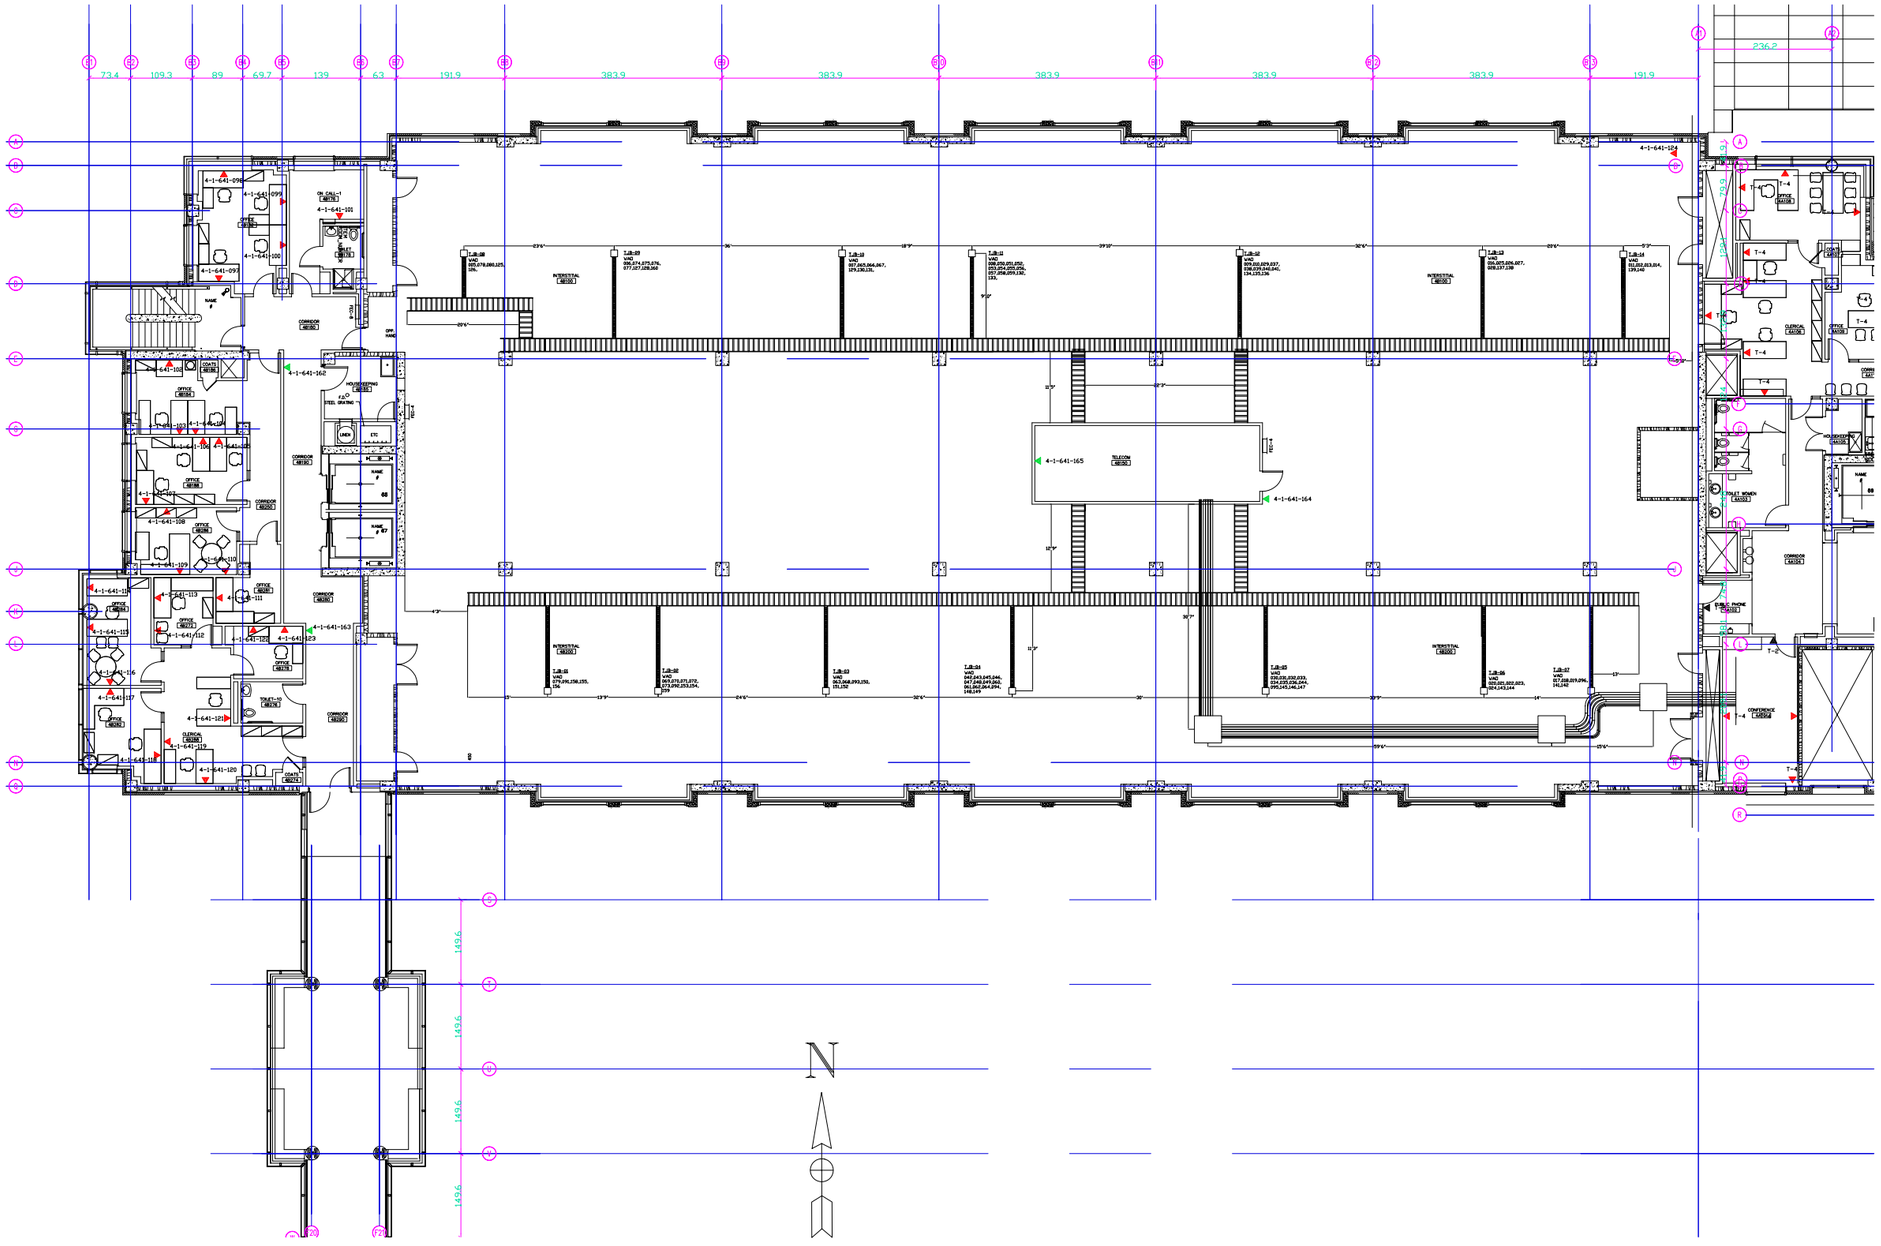

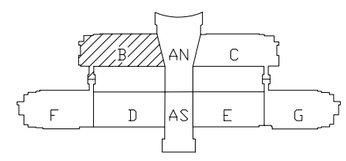

KEY PLAN

Architecture
Engineering
Planning
Interior Design
Computer Aided Design

REVISIONS			
ZONE	REV	DESCRIPTION	DATE	APPROVED

JOB NO.

SIZE E

SCALE: 1/8"=1'

JOB TITLE: NIH – CRC CABLING SYSTEMS

FLOOR/AREA: FLOOR 4/AREA B

DRWG TITLE: PARTIAL PLAN

NATIONAL INSTITUTES OF HEALTH

DESIGNED BY: CIT/DNST
T. LIGHTNER
DIV. NIH/CIT/DNST

DEPARTMENT OF HEALTH & HUMAN SERVICES USA

TT2.4.B

DATE: 01/31/03

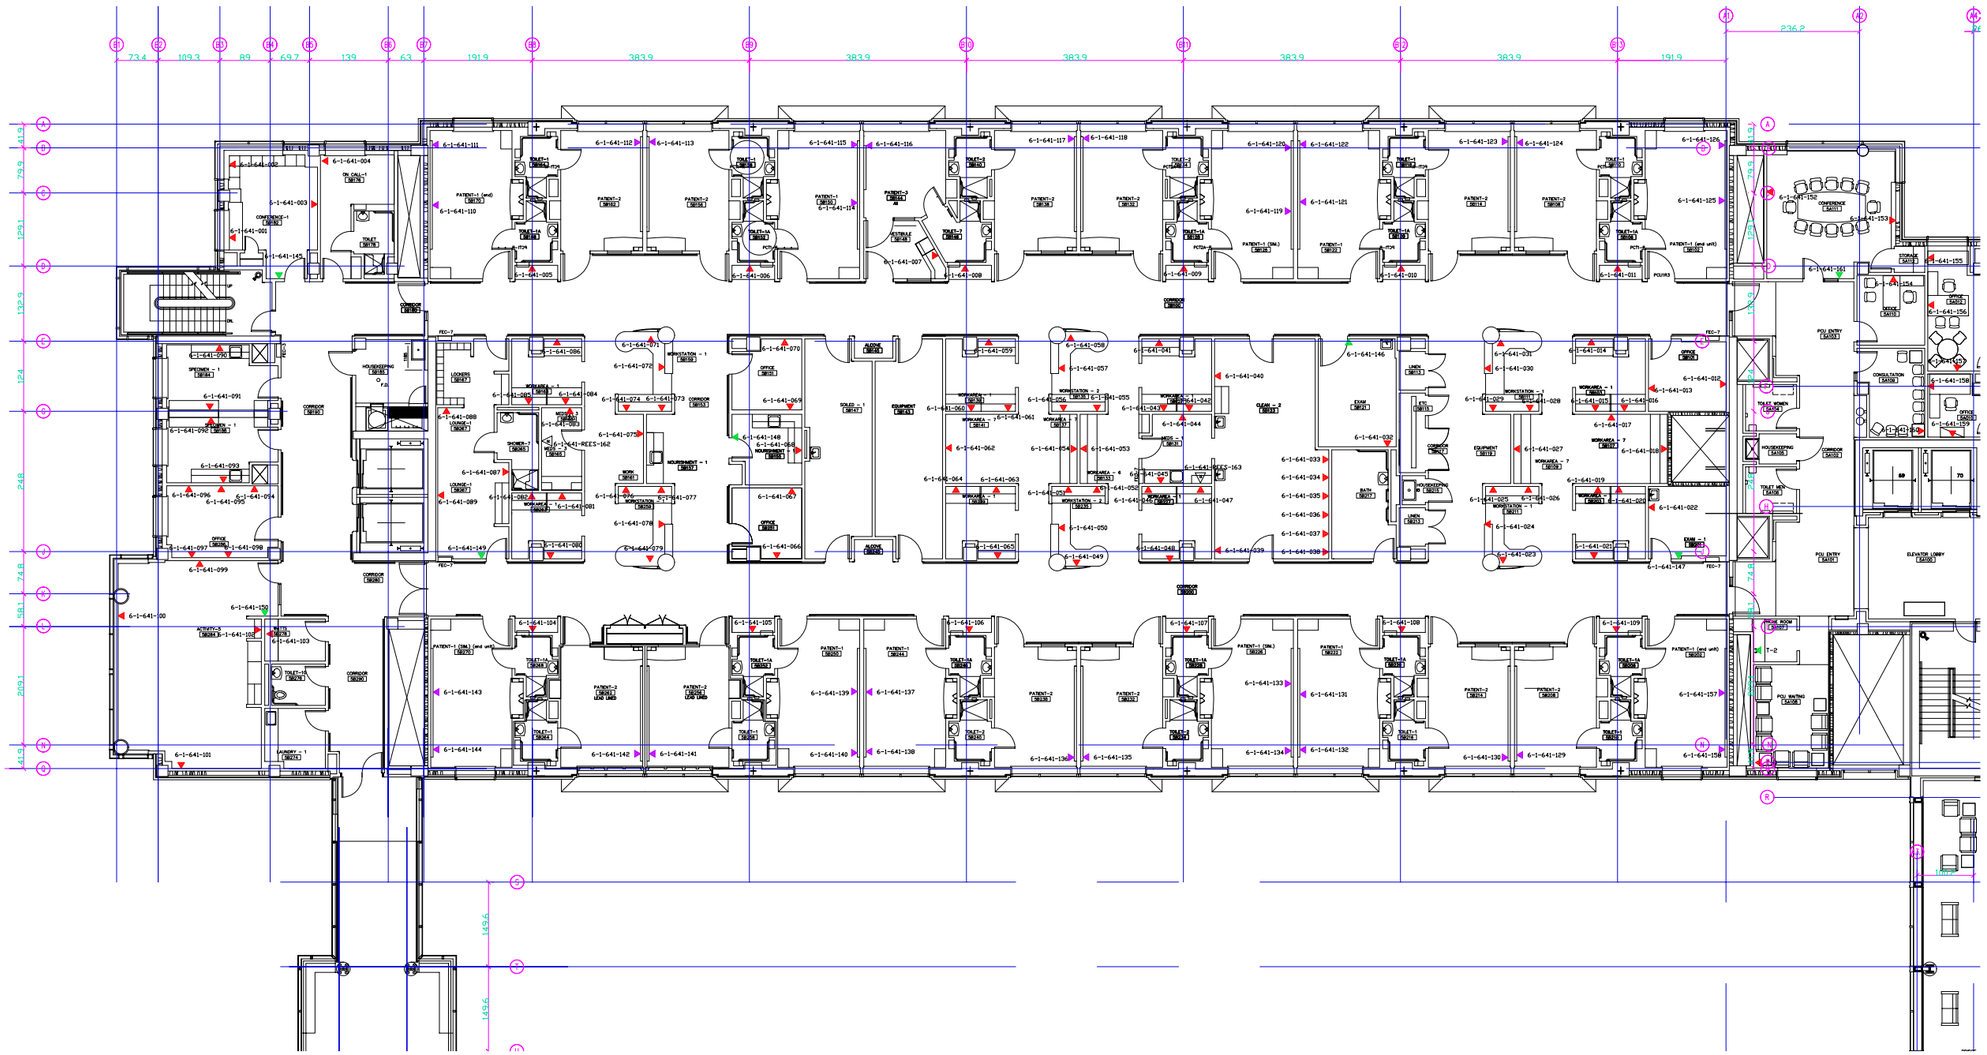

N

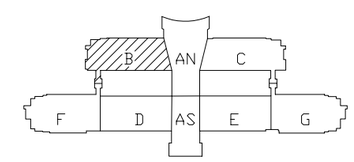

KEY PLAN

Architecture
Engineering
Planning
Interior Design
Computer Aided Design

REVISIONS			
ZONE	REV	DESCRIPTION	DATE	APPROVED

JOB NO.

SIZE E

SCALE: 1/8"=1'

JOB TITLE: NIH - CRC CABLING SYSTEMS

FLOOR/AREA: FLOOR 5/AREA 5

DRWG TITLE: PARTIAL PLAN

NATIONAL INSTITUTES OF HEALTH

DESIGNED BY: CIT/DNST
T. LIGHTNER
DIV. NIH/CIT/DNST

DEPARTMENT OF HEALTH & HUMAN SERVICES USA

TT2.5.B

DATE: 01/31/03

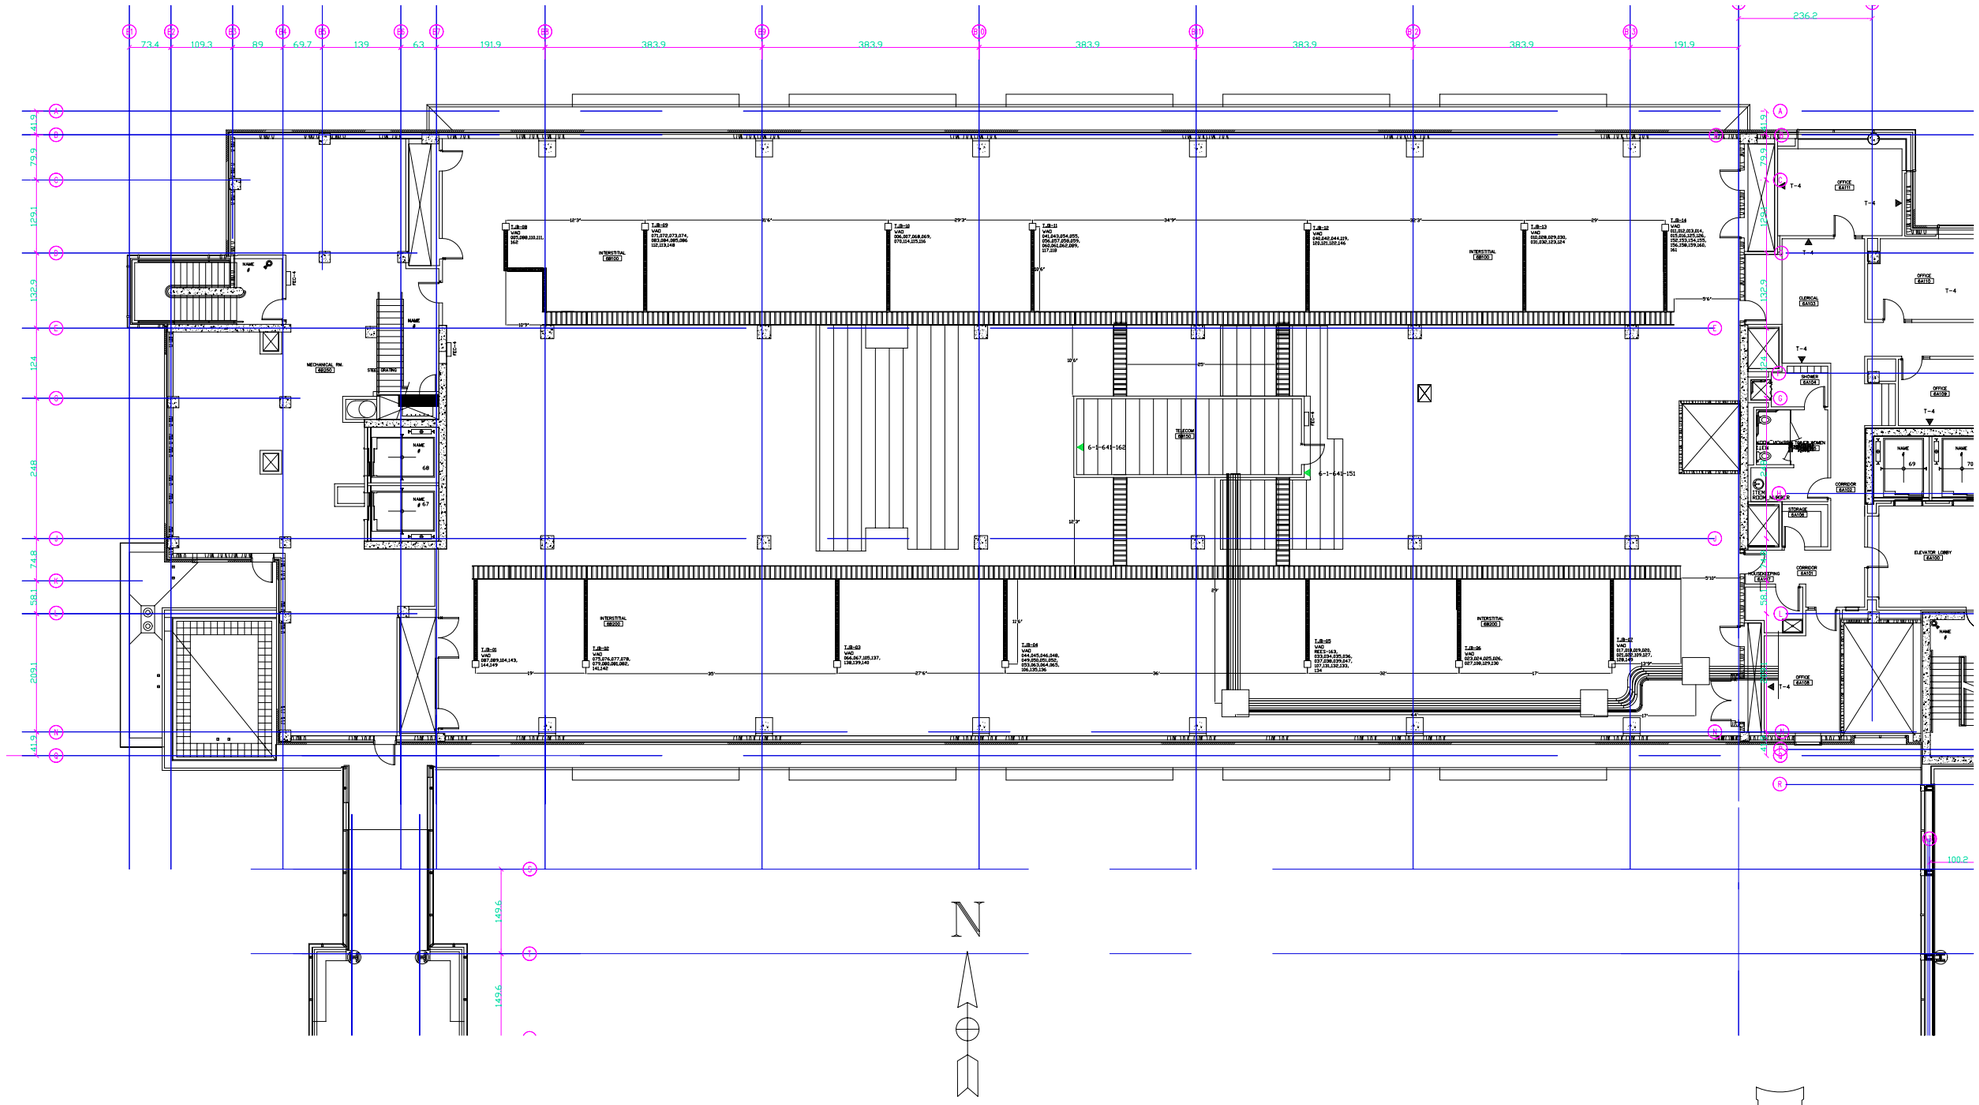

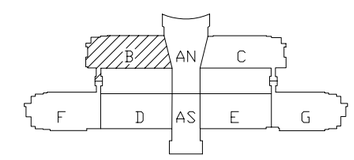

KEY PLAN

Architecture
Engineering
Planning
Interior Design
Computer Aided Design

REVISIONS			
ZONE	REV	DESCRIPTION	DATE	APPROVED

JOB NO.

SIZE E

SCALE: 1/8"=1'

JOB TITLE: NIH – CRC CABLING SYSTEMS

FLOOR/AREA: FLOOR 6/AREA B

DRWG TITLE: PARTIAL FLOOR

NATIONAL INSTITUTES OF HEALTH

DESIGNED BY: CIT/DNST
T. LIGHTNER
DIV. NIH/CIT/DNST

DEPARTMENT OF HEALTH & HUMAN SERVICES USA

TT2.6.B

DATE: 01/31/03

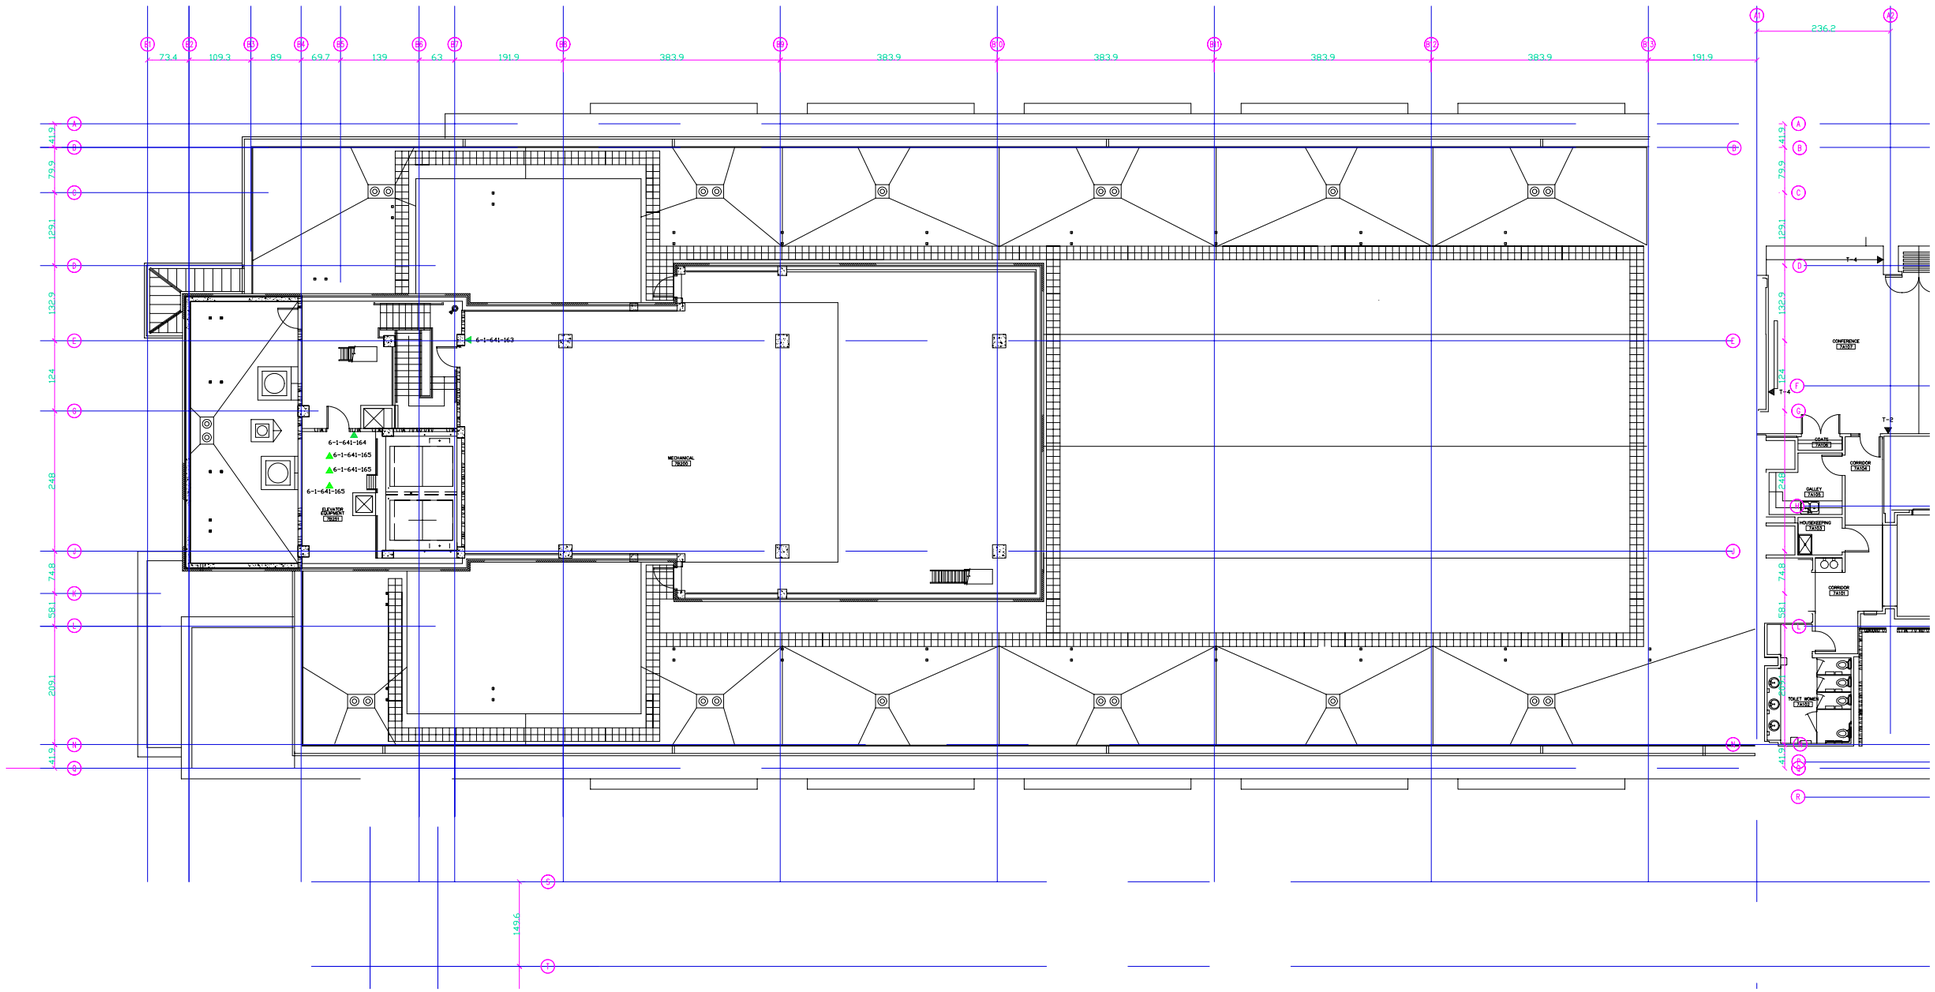

N

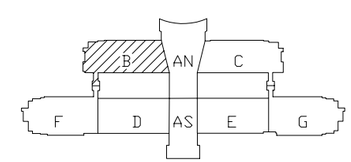

KEY PLAN

Architecture
Engineering
Planning
Interior Design
Computer Aided Design

REVISIONS			
ZONE	REV	DESCRIPTION	DATE	APPROVED

JOB NO.

SIZE E

SCALE: 1/8"=1'

JOB TITLE: NIH - CRC CABLING SYSTEMS

FLOOR/AREA: FLOOR 7/AREA B

DRWG TITLE: PARTIAL PLAN

NATIONAL INSTITUTES OF HEALTH

DESIGNED BY: CIT/DNST
T. LIGHTNER
DIV. NIH/CIT/DNST

DEPARTMENT OF HEALTH & HUMAN SERVICES USA

TT2.7.B

DATE: 01/31/03