New Revision (in magenta) due to construction plans. Work area outlets may not be in consecutive running order in this area.

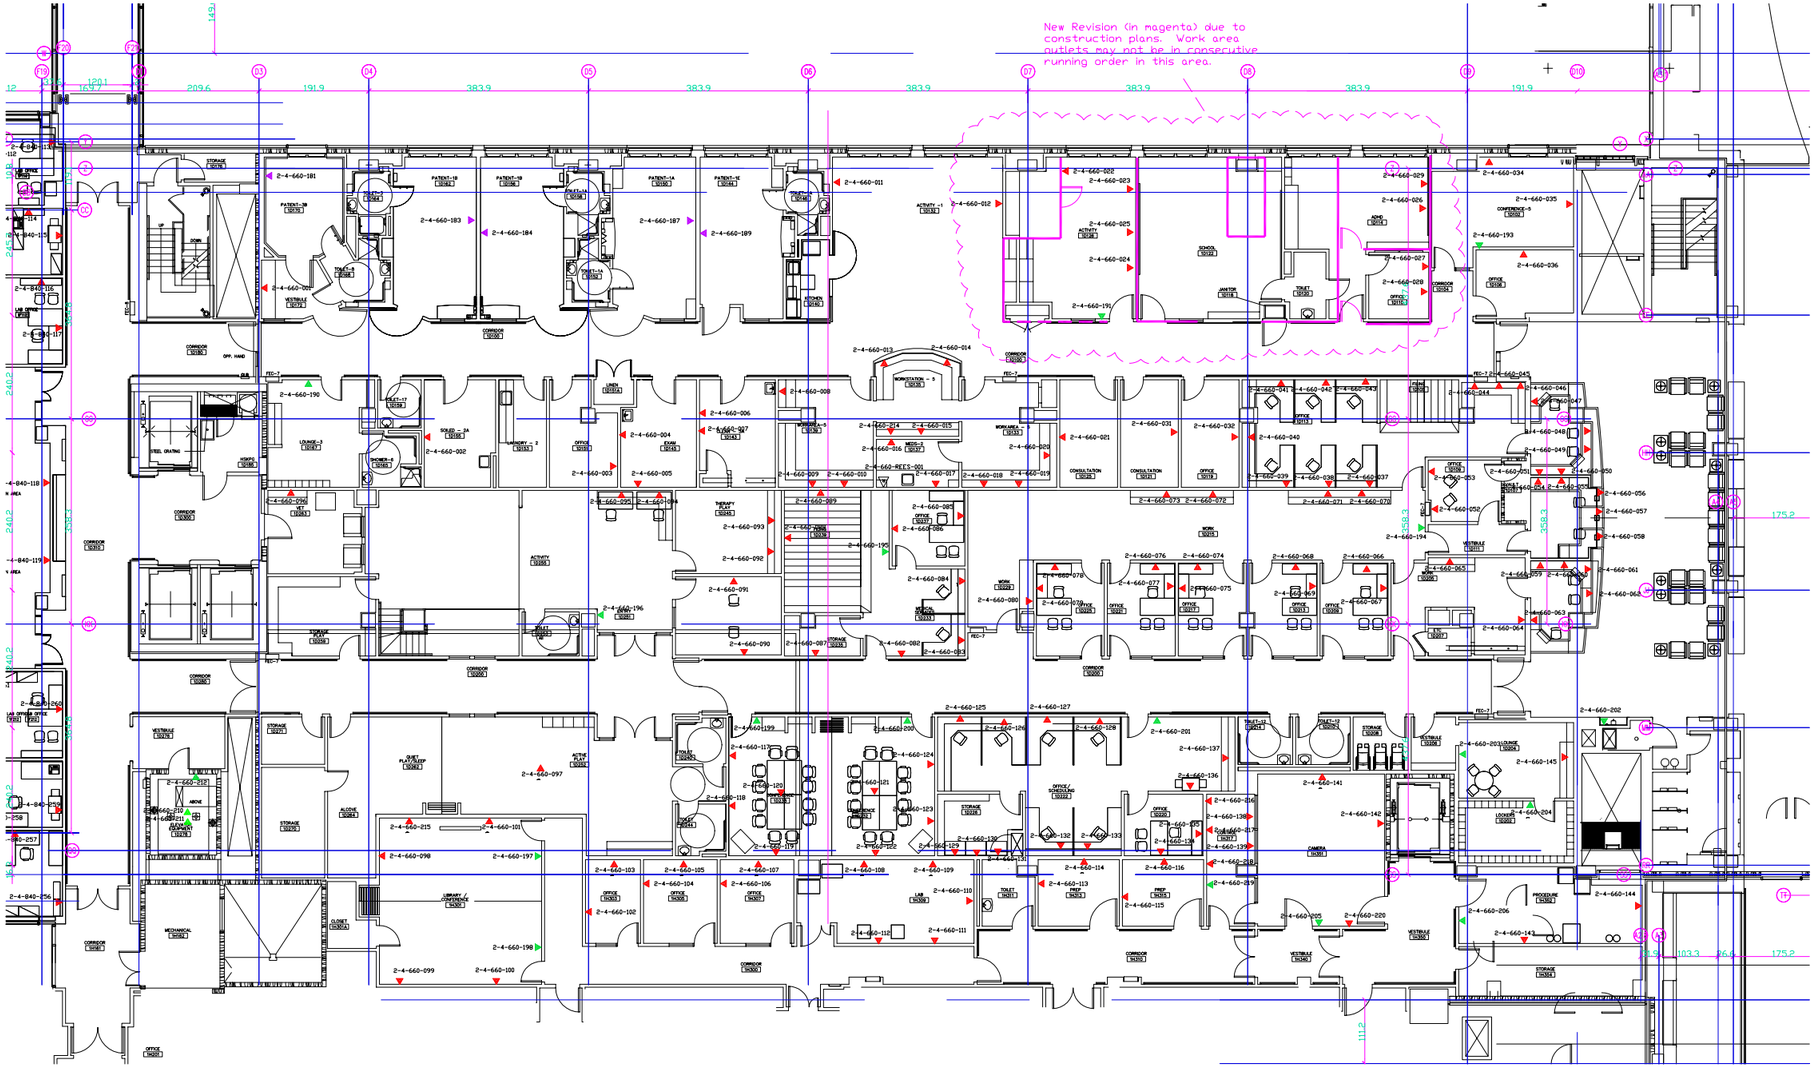

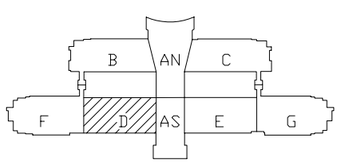

KEY PLAN

Architecture
Engineering
Planning
Interior Design
Computer Aided Design

REVISIONS			
ZONE	REV	DESCRIPTION	DATE	APPROVED

JOB NO.

SIZE E

SCALE: 1/8"=1'

JOB TITLE: NIH – CRC CABLING SYSTEMS

FLOOR/AREA: FLOOR 1/AREA D

DRWG TITLE: PARTIAL PLAN

NATIONAL INSTITUTES OF HEALTH

DESIGNED BY: CIT/DNST
T. LIGHTNER
DIV. NIH/CIT/DNST

DEPARTMENT OF HEALTH & HUMAN SERVICES USA

TT2.1.D

DATE: 10/14/03

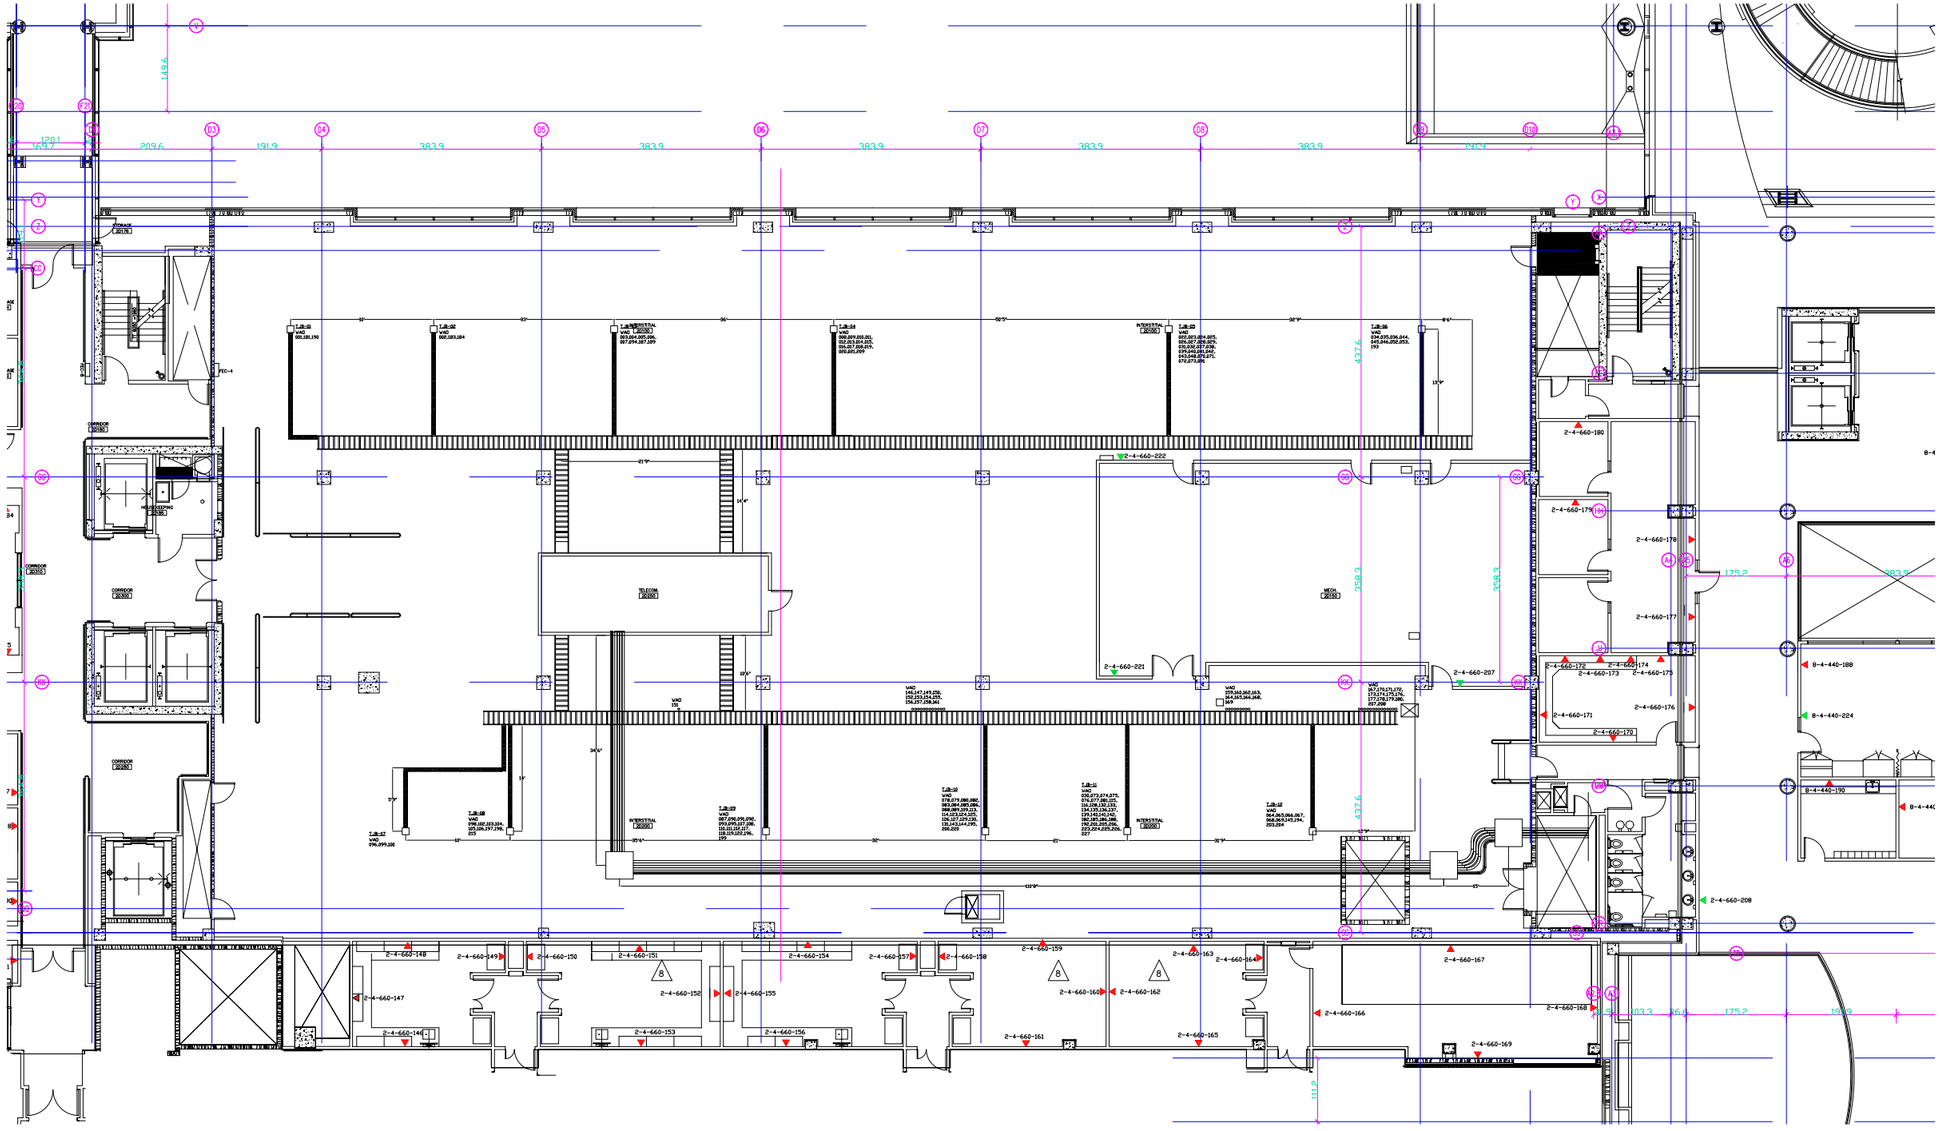

Architecture
Engineering
Planning
Interior Design
Computer Aided Design

REVISIONS			
ZONE	REV	DESCRIPTION	DATE	APPROVED

JOB NO.:

SIZE E

SCALE: 1/8"=1'

JOB TITLE: NIH – CRC CABLING SYSTEMS

FLOOR/AREA: FLOOR 2/AREA D

DRWG TITLE: PARTIAL PLAN

NATIONAL INSTITUTES OF HEALTH

DESIGNED BY:CIT/DNST
T. LIGHTNER
DIV. NIH/CIT/DNST

DEPARTMENT OF HEALTH & HUMAN SERVICES USA

TT2.2.D

DATE: 01/31/03

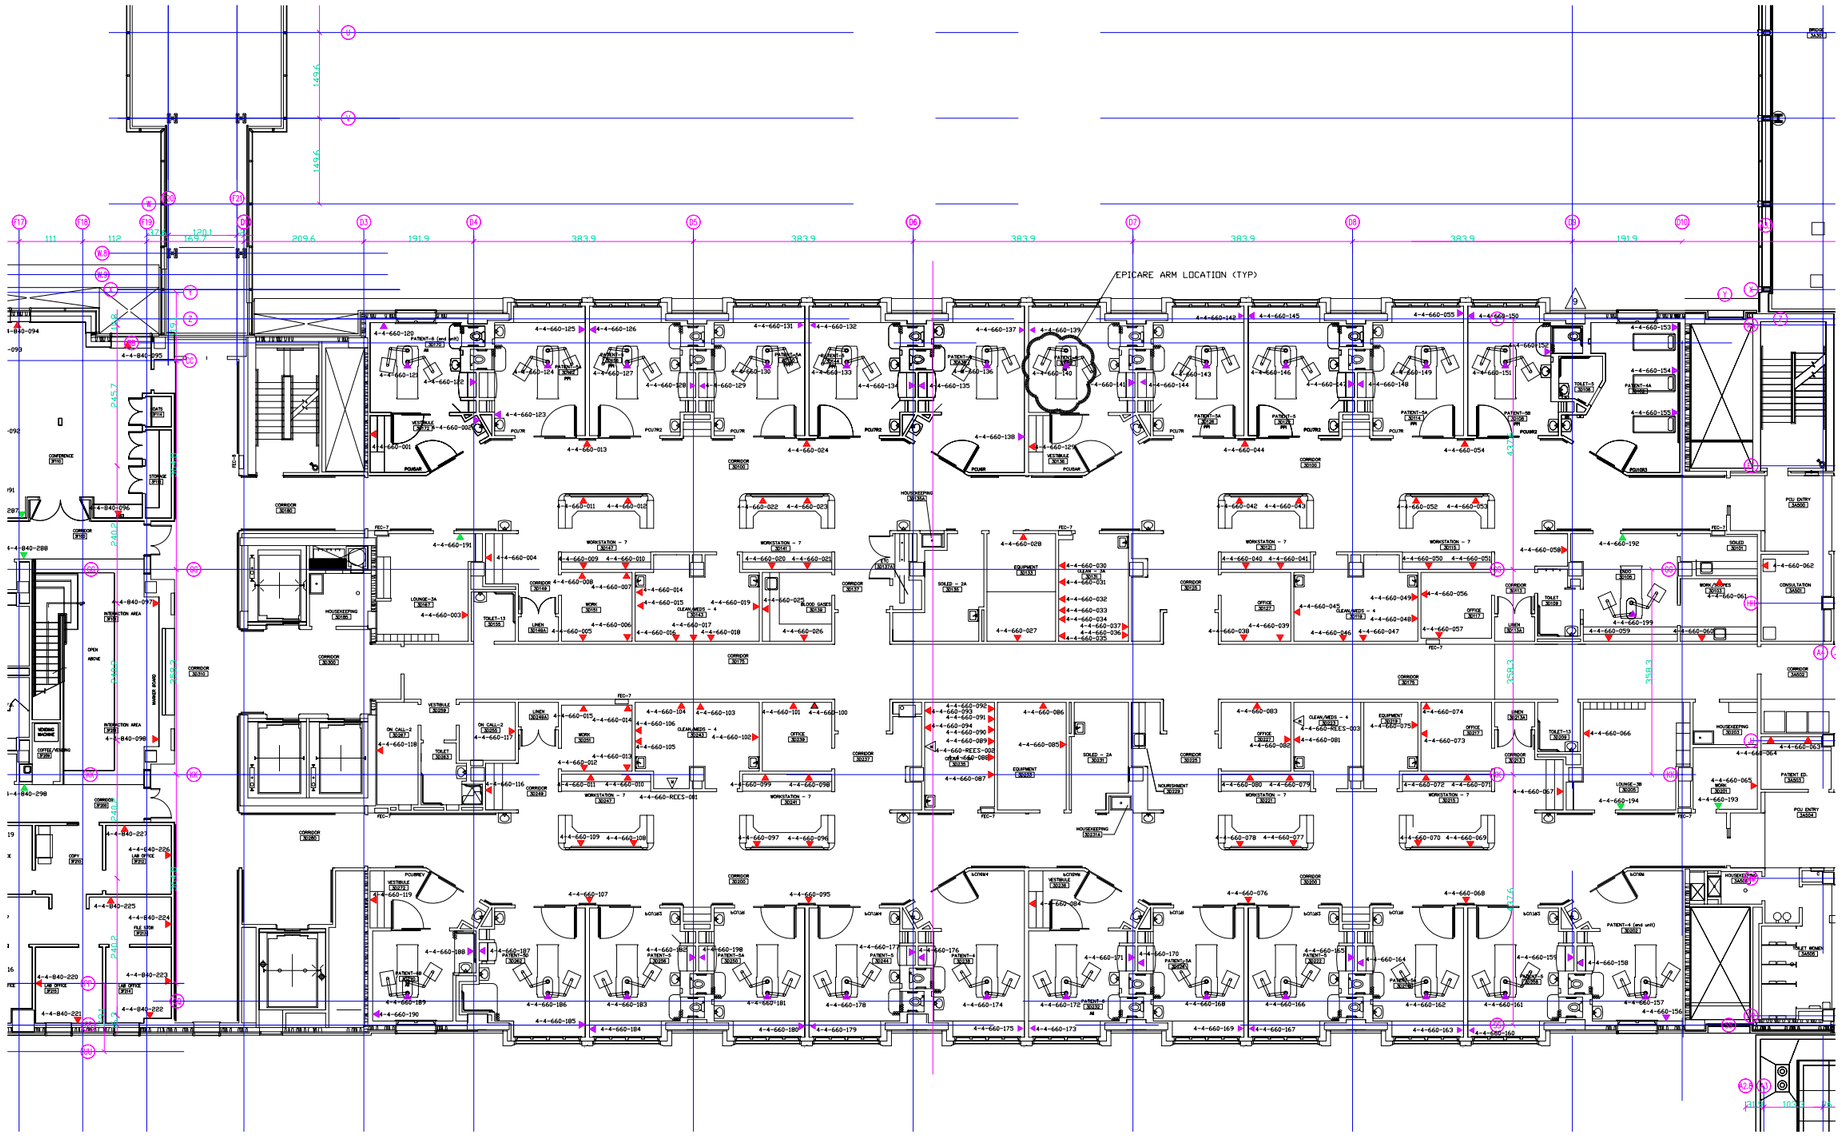

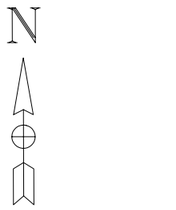

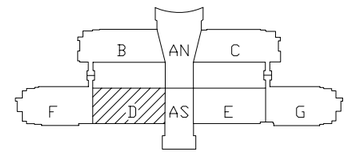

KEY PLAN

Architecture
Engineering
Planning
Interior Design
Computer Aided Design

REVISIONS			
ZONE	REV	DESCRIPTION	DATE	APPROVED

JOB NO.

SIZE E

SCALE: 1/8"=1'

JOB TITLE: NIH – CRC CABLING SYSTEMS

FLOOR/AREA: FLOOR 3/AREA D

DRWG TITLE: PARTIAL PLAN

NATIONAL INSTITUTES OF HEALTH

DESIGNED BY: CIT/DNST
T. LIGHTNER
DIV. NIH/CIT/DNST

DEPARTMENT OF HEALTH & HUMAN SERVICES USA

TT2.3.D

DATE: 01/31/03

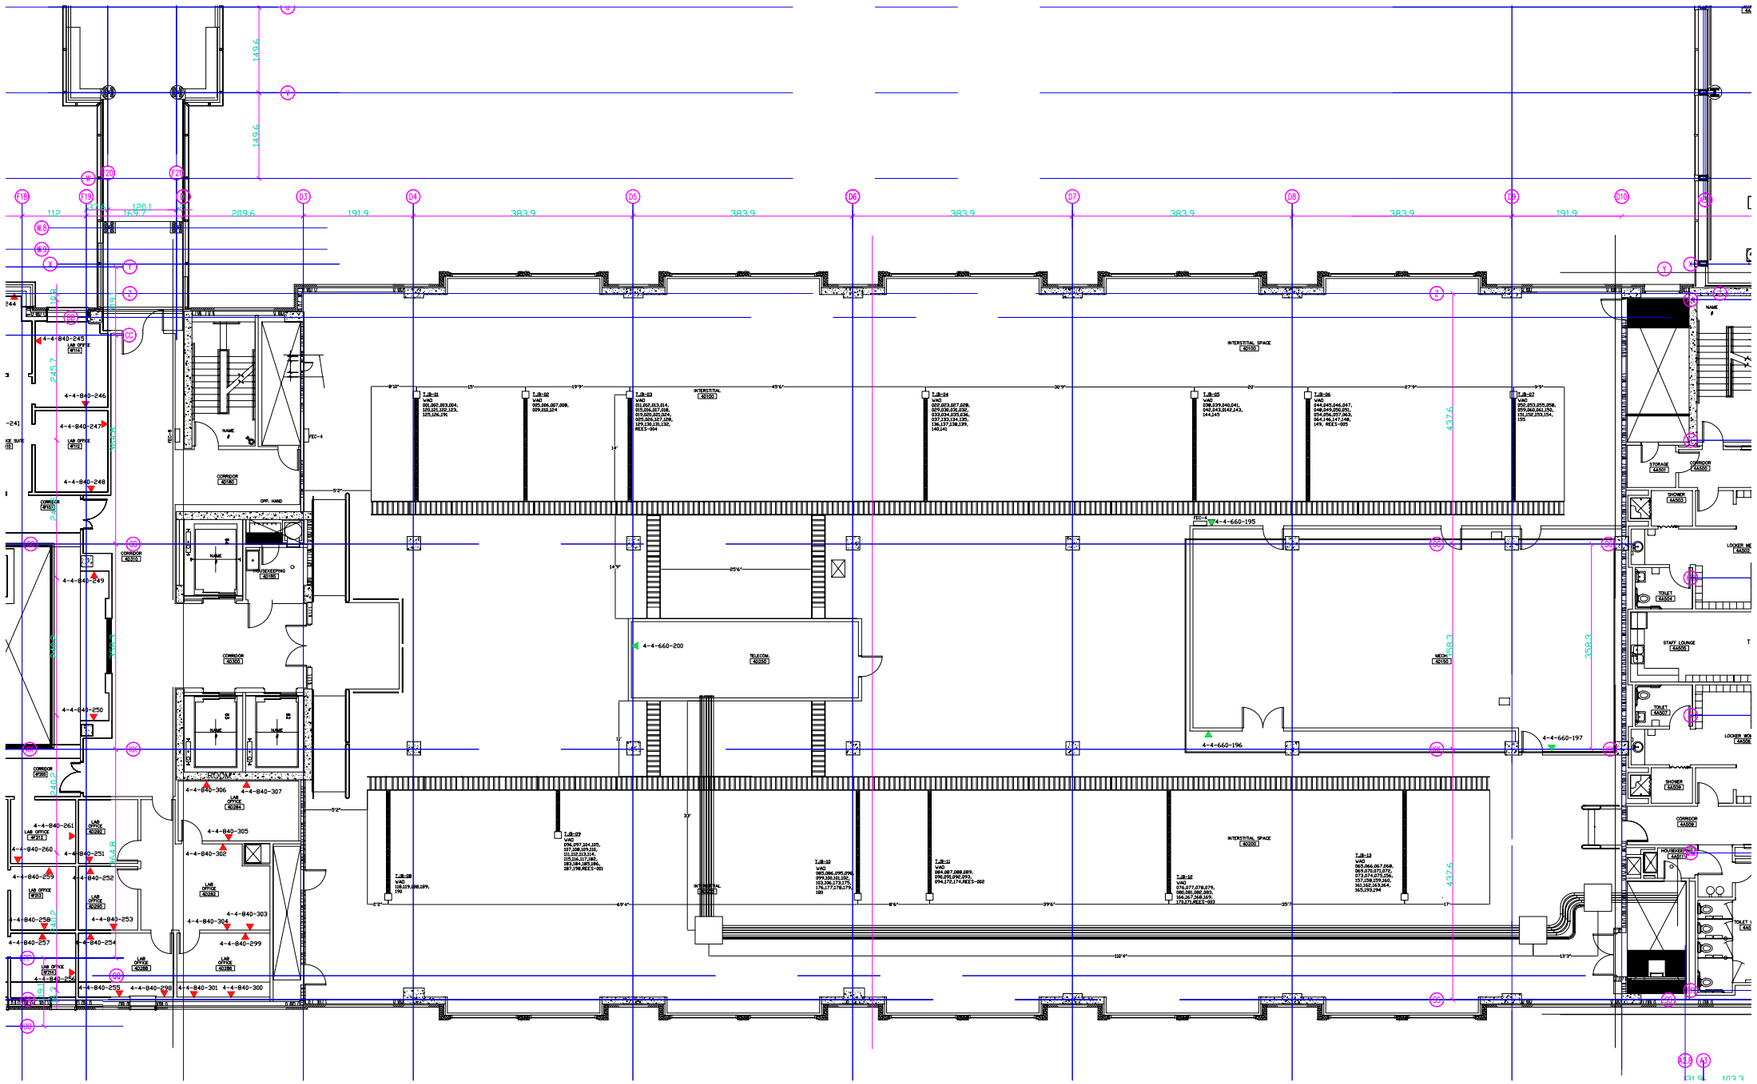

N

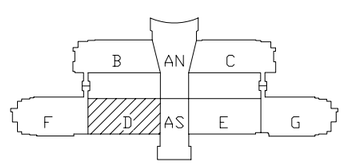

KEY PLAN

Architecture
Engineering
Planning
Interior Design
Computer Aided Design

REVISIONS				
ZONE	REV	DESCRIPTION	DATE	APPROVED

JOB NO.:

SIZE E

SCALE: 1/8" = 1'

JOB TITLE: NIH – CRC CABLING SYSTEMS

FLOOR/AREA: FLOOR 4/AREA D

DRWG TITLE: PARTIAL PLAN

NATIONAL INSTITUTES OF HEALTH

DESIGNED BY: CIT/DNST
T. LIGHTNER
DIV. NIH/CIT/DNST

DEPARTMENT OF HEALTH & HUMAN SERVICES USA

TT2.4.D

DATE: 01/31/03

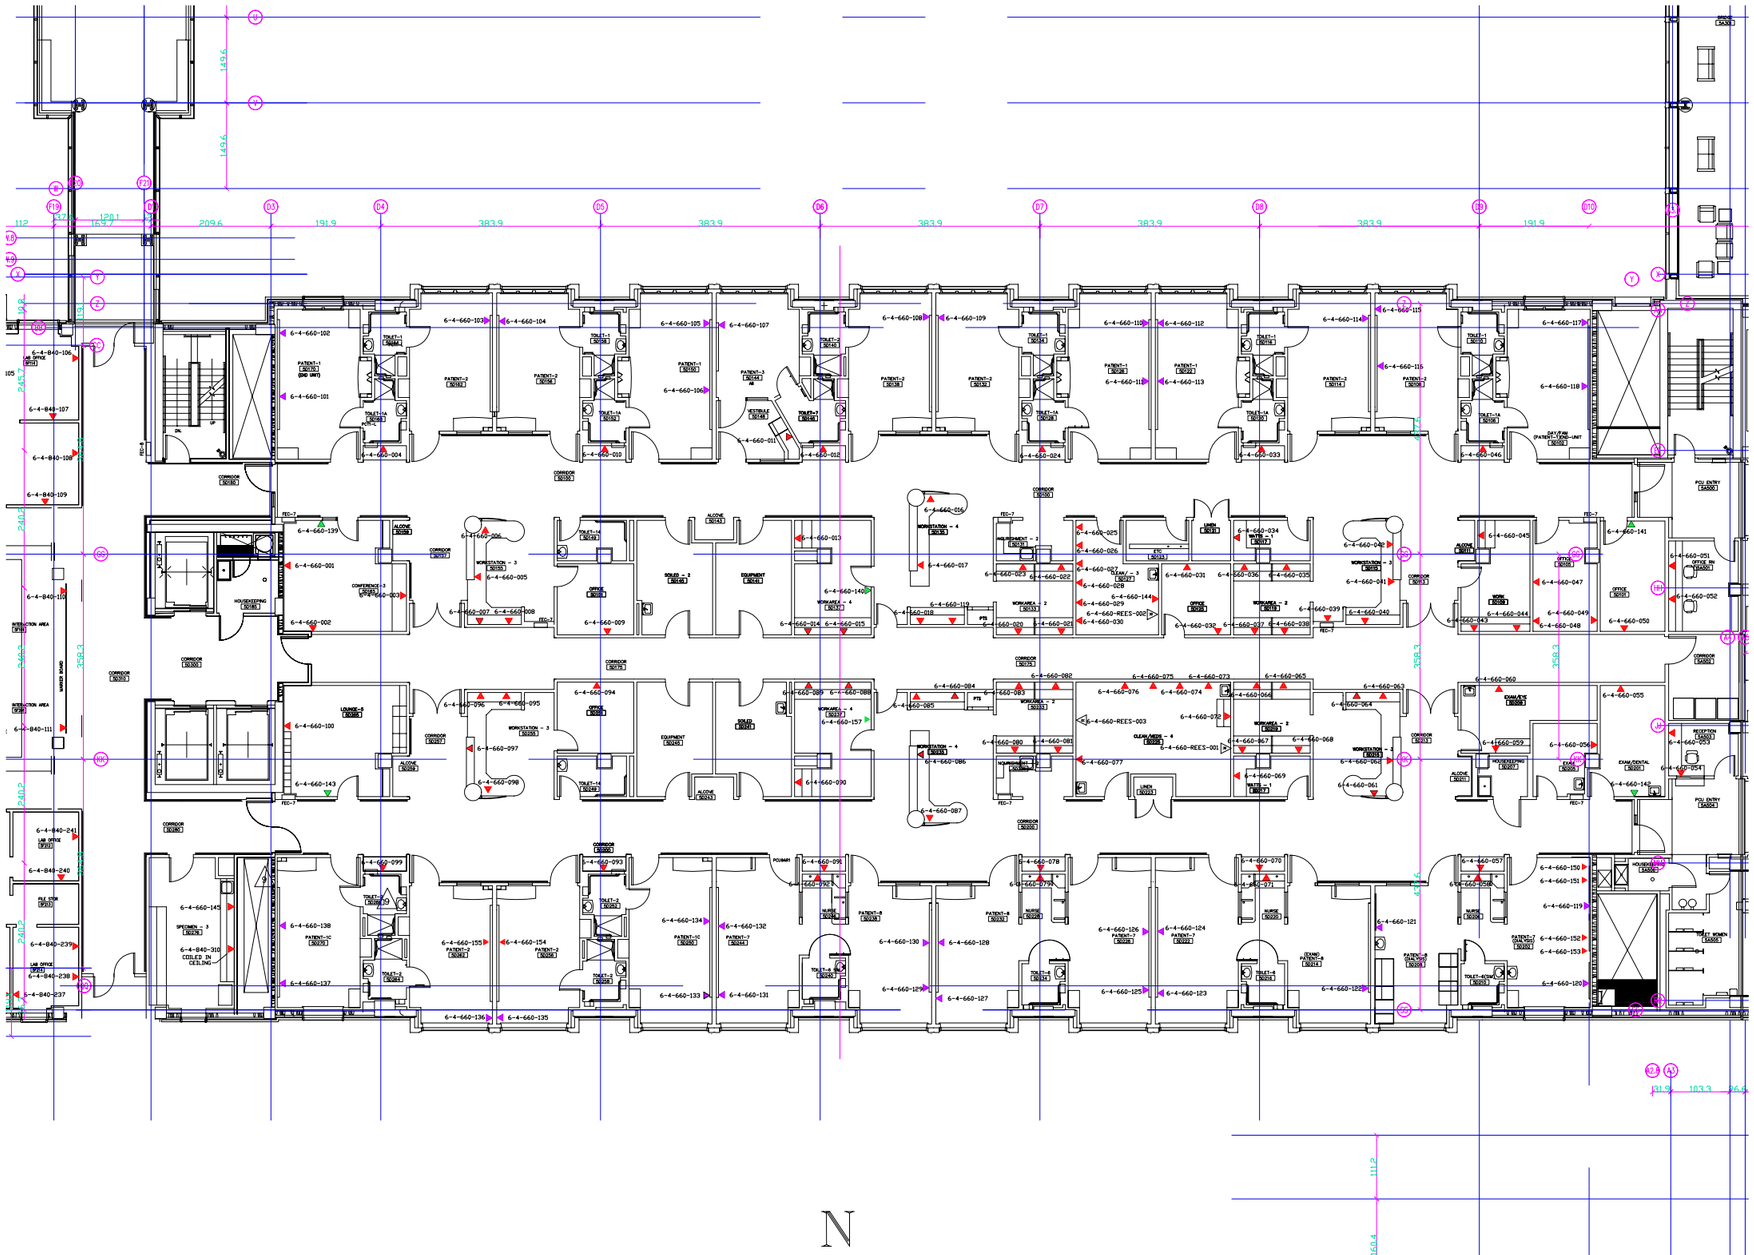

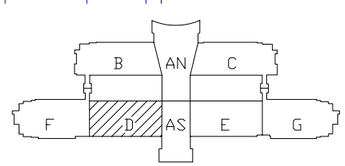

KEY PLAN

Architecture
Engineering
Planning
Interior Design
Computer Aided Design

REVISIONS			
ZONE	REV	DESCRIPTION	DATE	APPROVED

JOB NO.:

SIZE E

SCALE: 1/8" = 1'

JOB TITLE: NIH – CRC CABLING SYSTEMS

FLOOR/AREA: FLOOR 5/AREA D

DRWG TITLE: PARTIAL PLAN

NATIONAL INSTITUTES OF HEALTH

DESIGNED BY: CIT/DNST
T. LIGHTNER
DIV. NIH/CIT/DNST

DEPARTMENT OF HEALTH & HUMAN SERVICES USA

TT2.5.D

DATE: 01/31/03

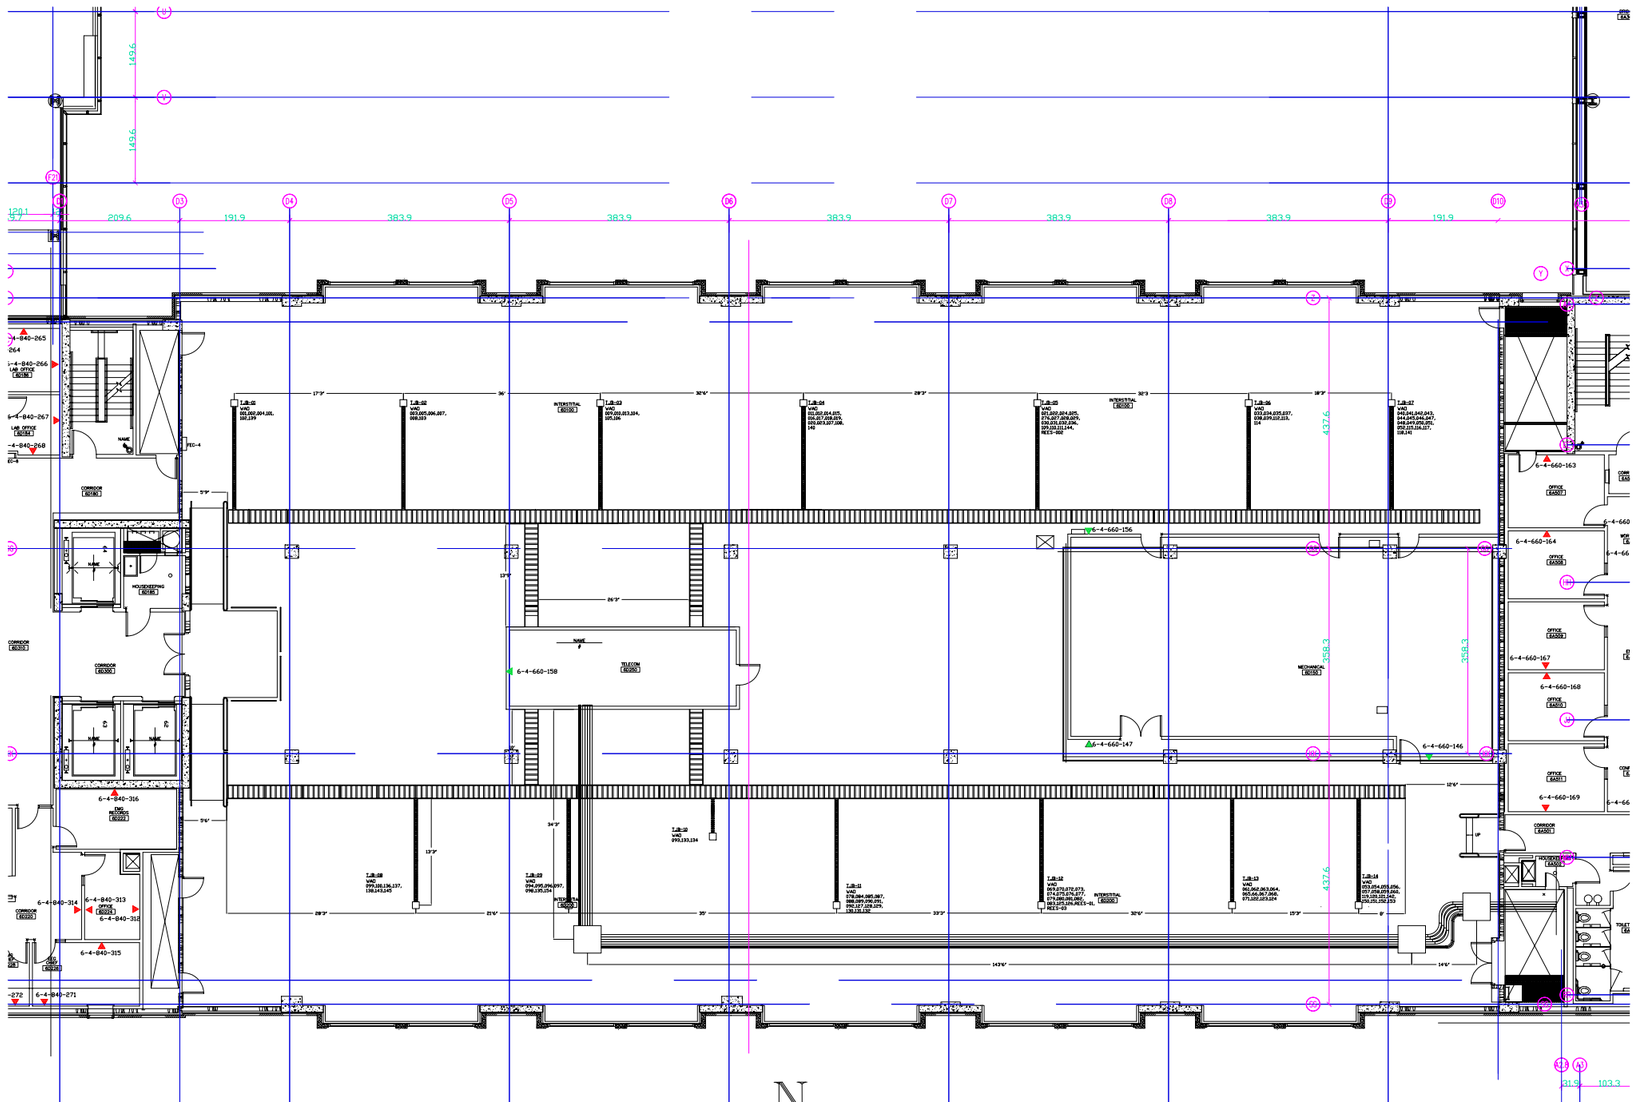

Architecture
Engineering
Planning
Interior Design
Computer Aided Design

REVISIONS

ZONE	REV	DESCRIPTION	DATE	APPROVED

JOB NO.:

SIZE E

SCALE: 1/8" = 1'

JOB TITLE: NIH - CRC CABLING SYSTEMS

FLOOR/AREA: FLOOR 6/AREA D

DRWG TITLE: PARTIAL FLOOR

NATIONAL INSTITUTES OF HEALTH

DESIGNED BY: CIT/DNST
T. LIGHTNER
DIV. NIH/CIT/DNST

DEPARTMENT OF HEALTH & HUMAN SERVICES USA

TT2.6.D

DATE: 01/31/03

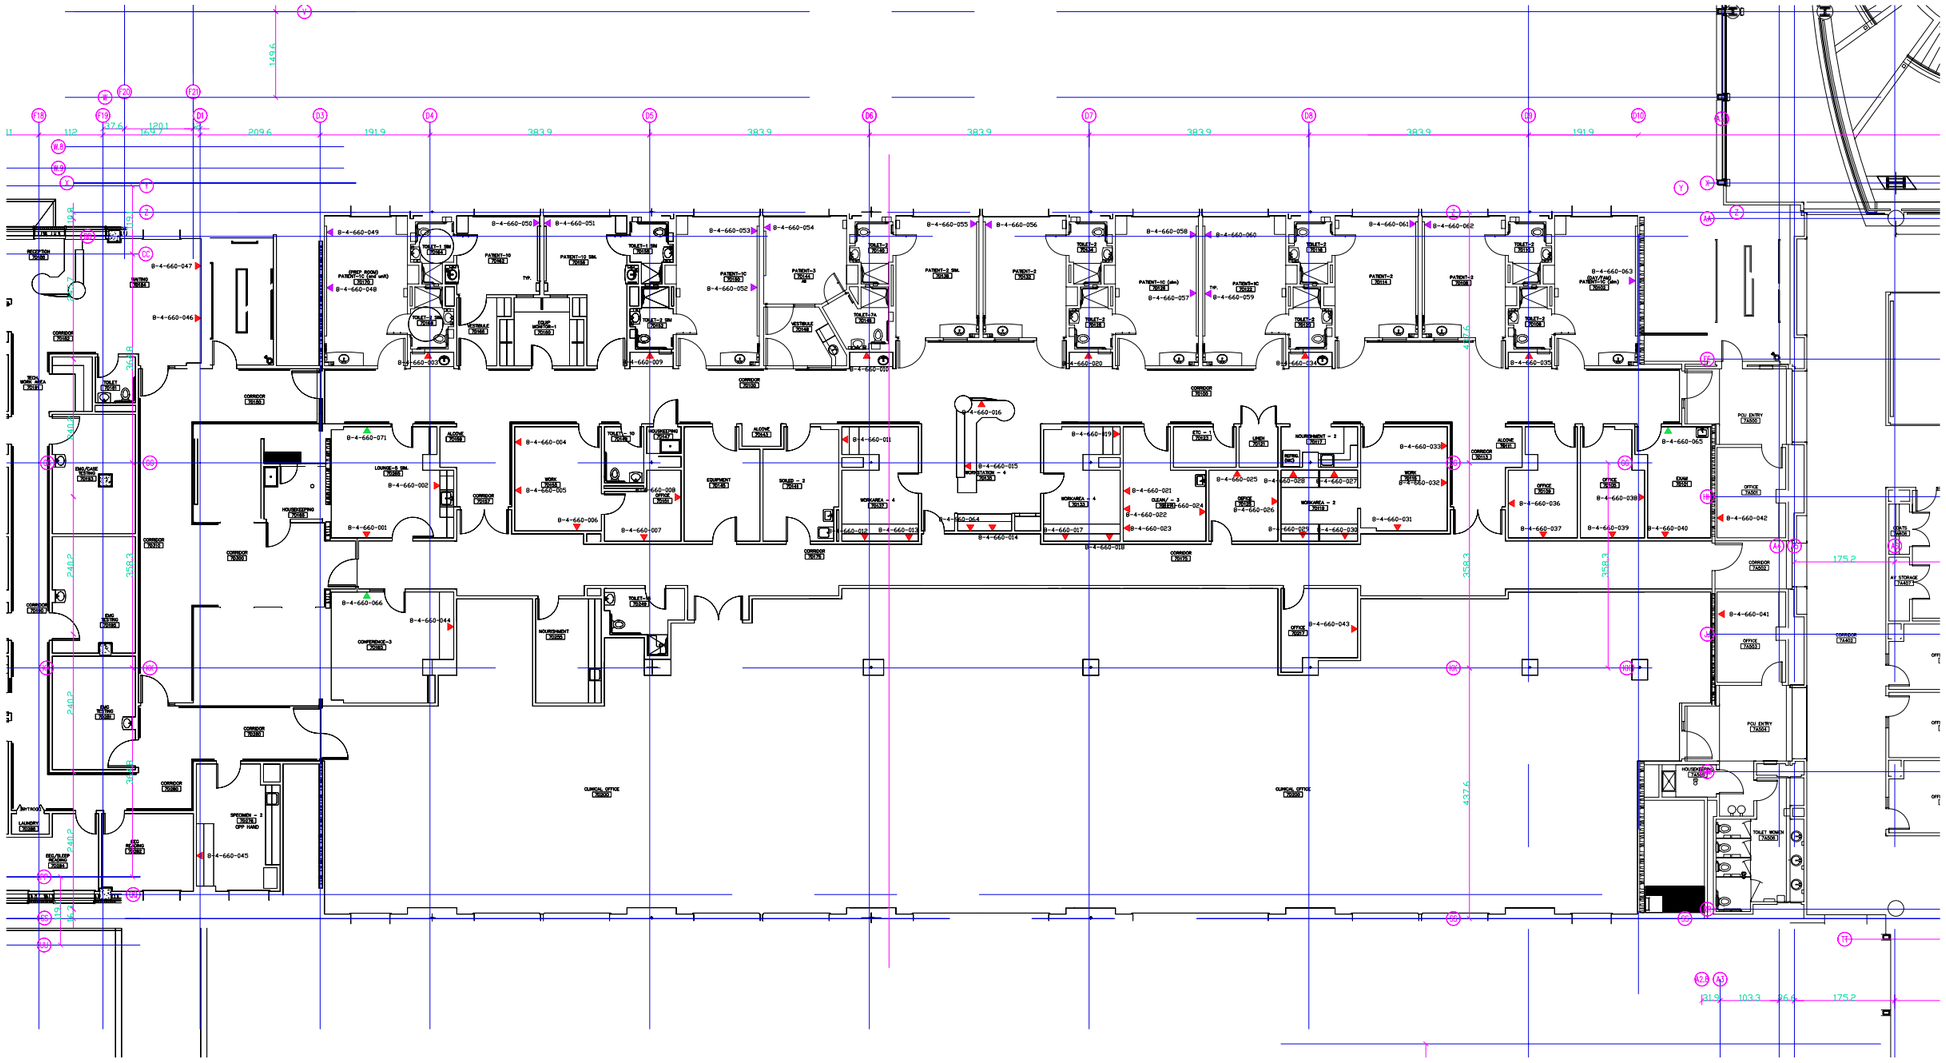

N

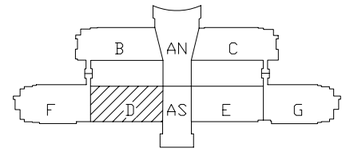

KEY PLAN

Architecture
Engineering
Planning
Interior Design
Computer Aided Design

REVISIONS			
ZONE	REV	DESCRIPTION	DATE APPROVED

JOB NO.:

SIZE E

SCALE: 1/8"=1'

JOB TITLE: NIH – CRC CABLING SYSTEMS

FLOOR/AREA: FLOOR 7/AREA D

DRWG TITLE: PARTIAL PLAN

NATIONAL INSTITUTES OF HEALTH

DESIGNED BY: CIT/DNST
T. LIGHTNER
DIV. NIH/CIT/DNST

DEPARTMENT OF HEALTH & HUMAN SERVICES USA

TT2.7.D

DATE: 01/31/03

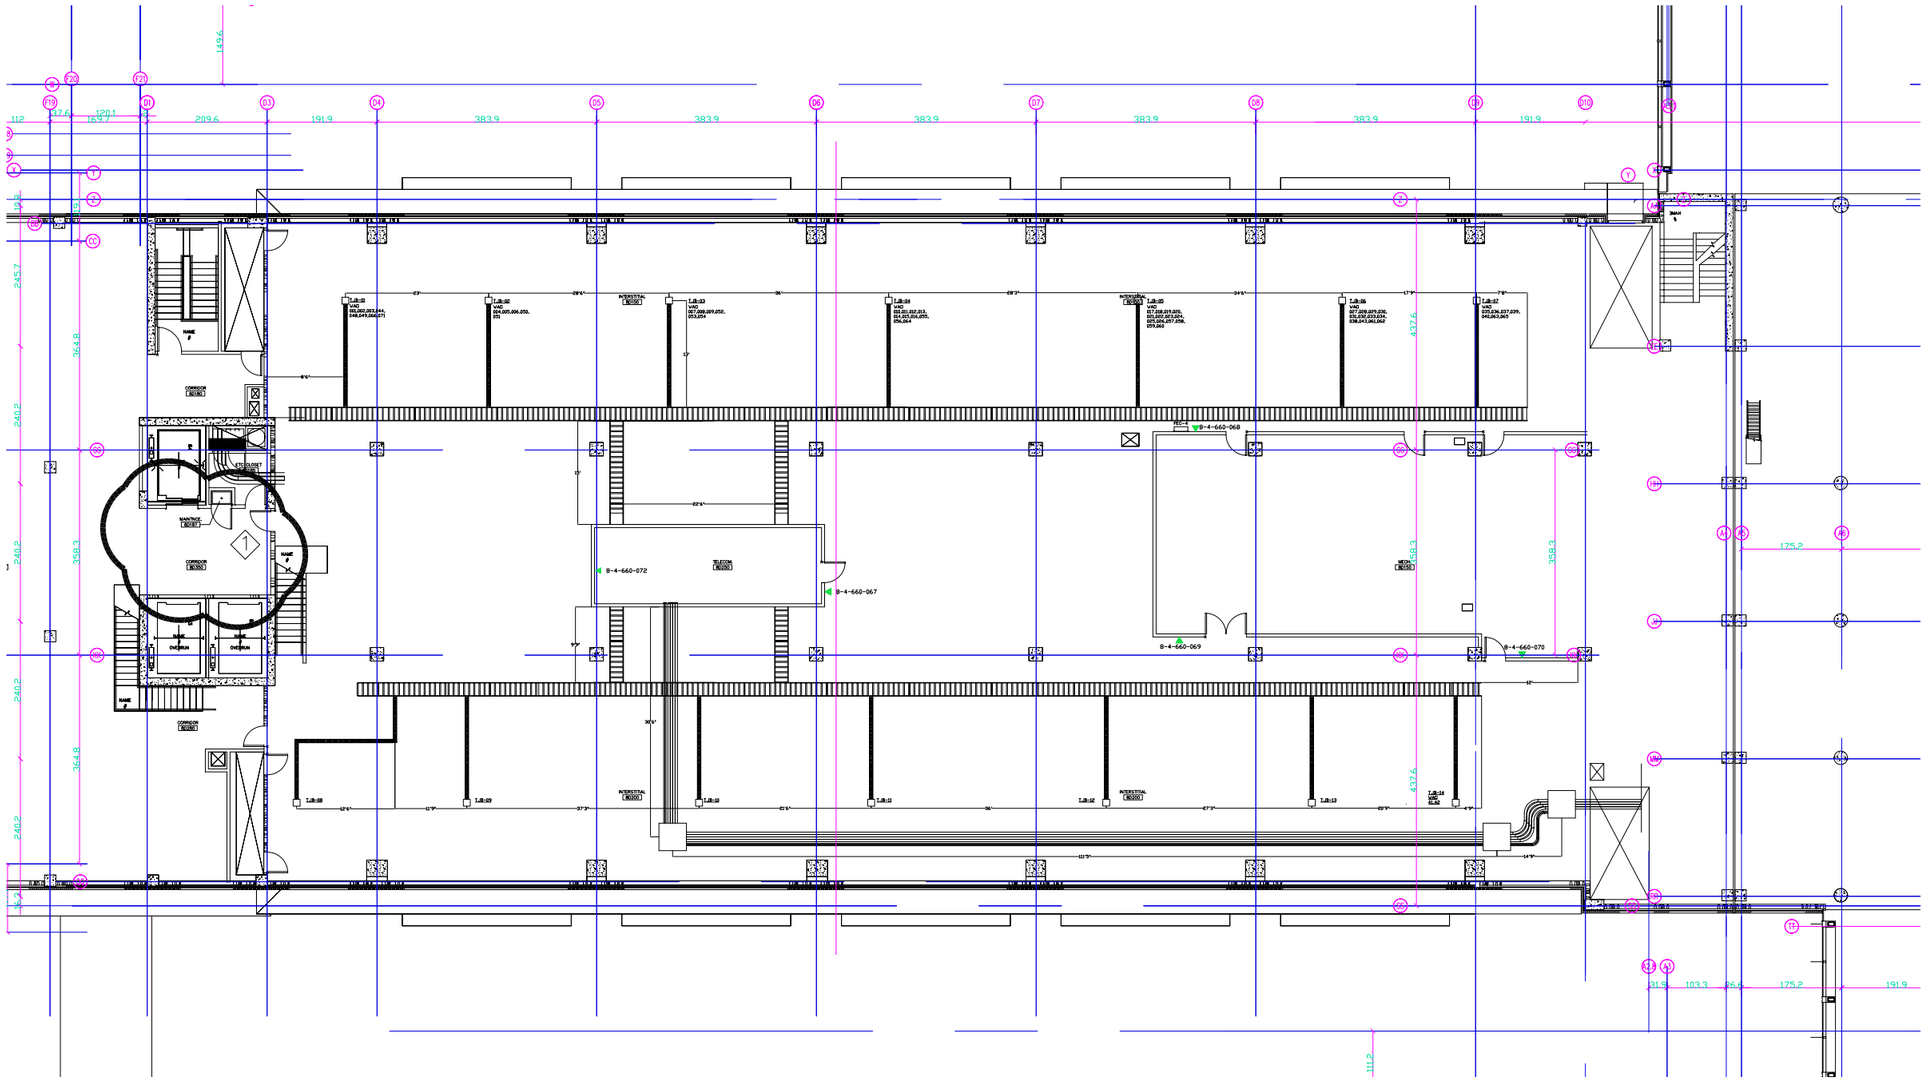

NOTES:

1. INSTALL ONE (1) "W" AND FOUR (4) "E" DROPS FOR ELEVATOR MACHINE ROOM ON 9TH FLOOR ABOVE.

N

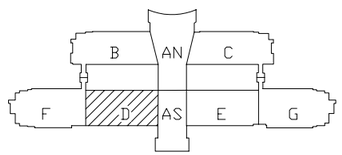

KEY PLAN

Architecture
Engineering
Planning
Interior Design
Computer Aided Design

REVISIONS			
ZONE	REV	DESCRIPTION	DATE	APPROVED

JOB NO.:

SIZE E

SCALE: 1/8"=1'

JOB TITLE: NIH – CRC CABLING SYSTEMS

FLOOR/AREA: FLOOR 8/AREA D

DRWG TITLE: PARTIAL PLAN

NATIONAL INSTITUTES OF HEALTH

DESIGNED BY: CIT/DNST
T. LIGHTNER
DIV. NIH/CIT/DNST

DEPARTMENT OF HEALTH & HUMAN SERVICES USA

TT2.8.D

DATE: 01/31/03